6TH FLOOR PLAN

SCALE :- 1:100 (WING - A)

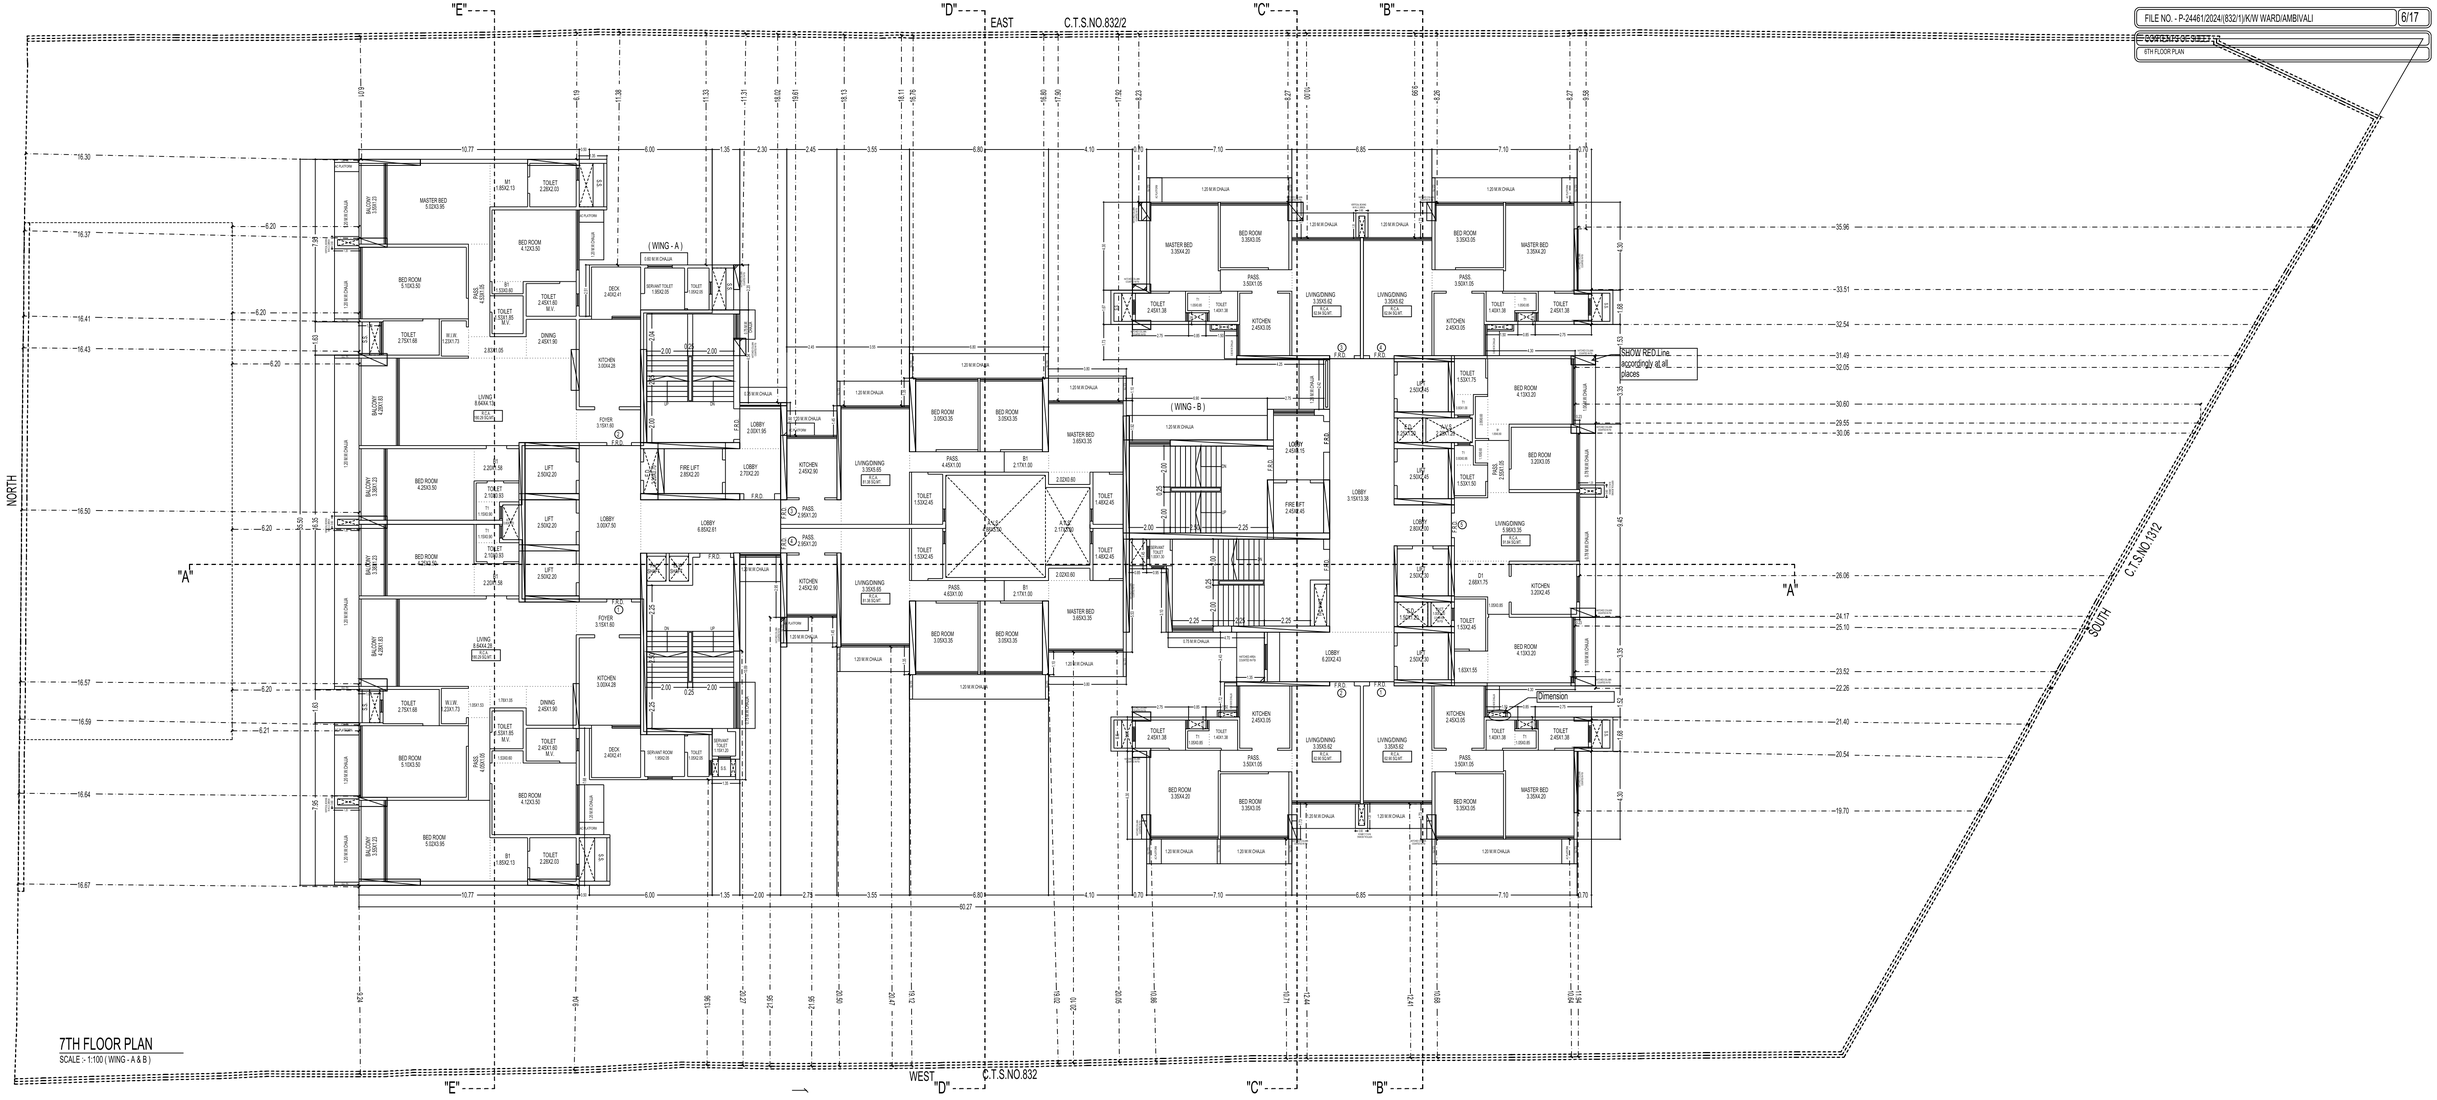
FILE NO. - P-24461/2024/(832/1)/K/W WARD/AMBIVALI
6/17
"E"
"D"
"C"
"B"
"A"
EAST
WEST
NORTH
SOUTH
C.T.S.NO.832/2
C.T.S.NO.832
C.T.S.NO.1312
(WING - A)
(WING - B)
SHOW RED Line accordingly at all places
Dimension
7TH FLOOR PLAN
SCALE :- 1:100 (WING - A & B)

FILE NO. - P-24461/2024/(832/1)/K/W WARd/AMBIVALI 7/17

8TH FLOOR PLAN

8TH FLOOR PLAN

SCALE :- 1:100 (WING - A & B)

BUILT UP AREA CALCULATION

BUILT UP AREA CALCULATION

8TH FLOOR (WING - B)

22.75	X	32.35	X	1NO	=	735.96	SQ.MT.

COLUMN AREA DIAGRAM

SCALE 1:100 (FOR 8TH FLOOR WING - B)

8TH FLOOR COLUMN AREA CALCULATION (WING - B)

1	0.40	X	0.90	X	2NOS	=	0.72	SQ.MT.
2	0.25	X	0.90	X	1NO	=	0.23	SQ.MT.
3	0.05	X	3.00	X	2NOS	=	0.30	SQ.MT.
4	0.70	X	0.30	X	2NOS	=	0.42	SQ.MT.
5	0.90	X	0.25	X	2NOS	=	0.45	SQ.MT.
6	1.00	X	0.40	X	2NOS	=	0.80	SQ.MT.
7	0.78	X	0.45	X	2NOS	=	0.70	SQ.MT.
8	0.25	X	1.20	X	1NO	=	0.30	SQ.MT.
9	0.25	X	0.53	X	2NOS	=	0.27	SQ.MT.
			TOTAL ADDITION			=	4.29	SQ.MT.

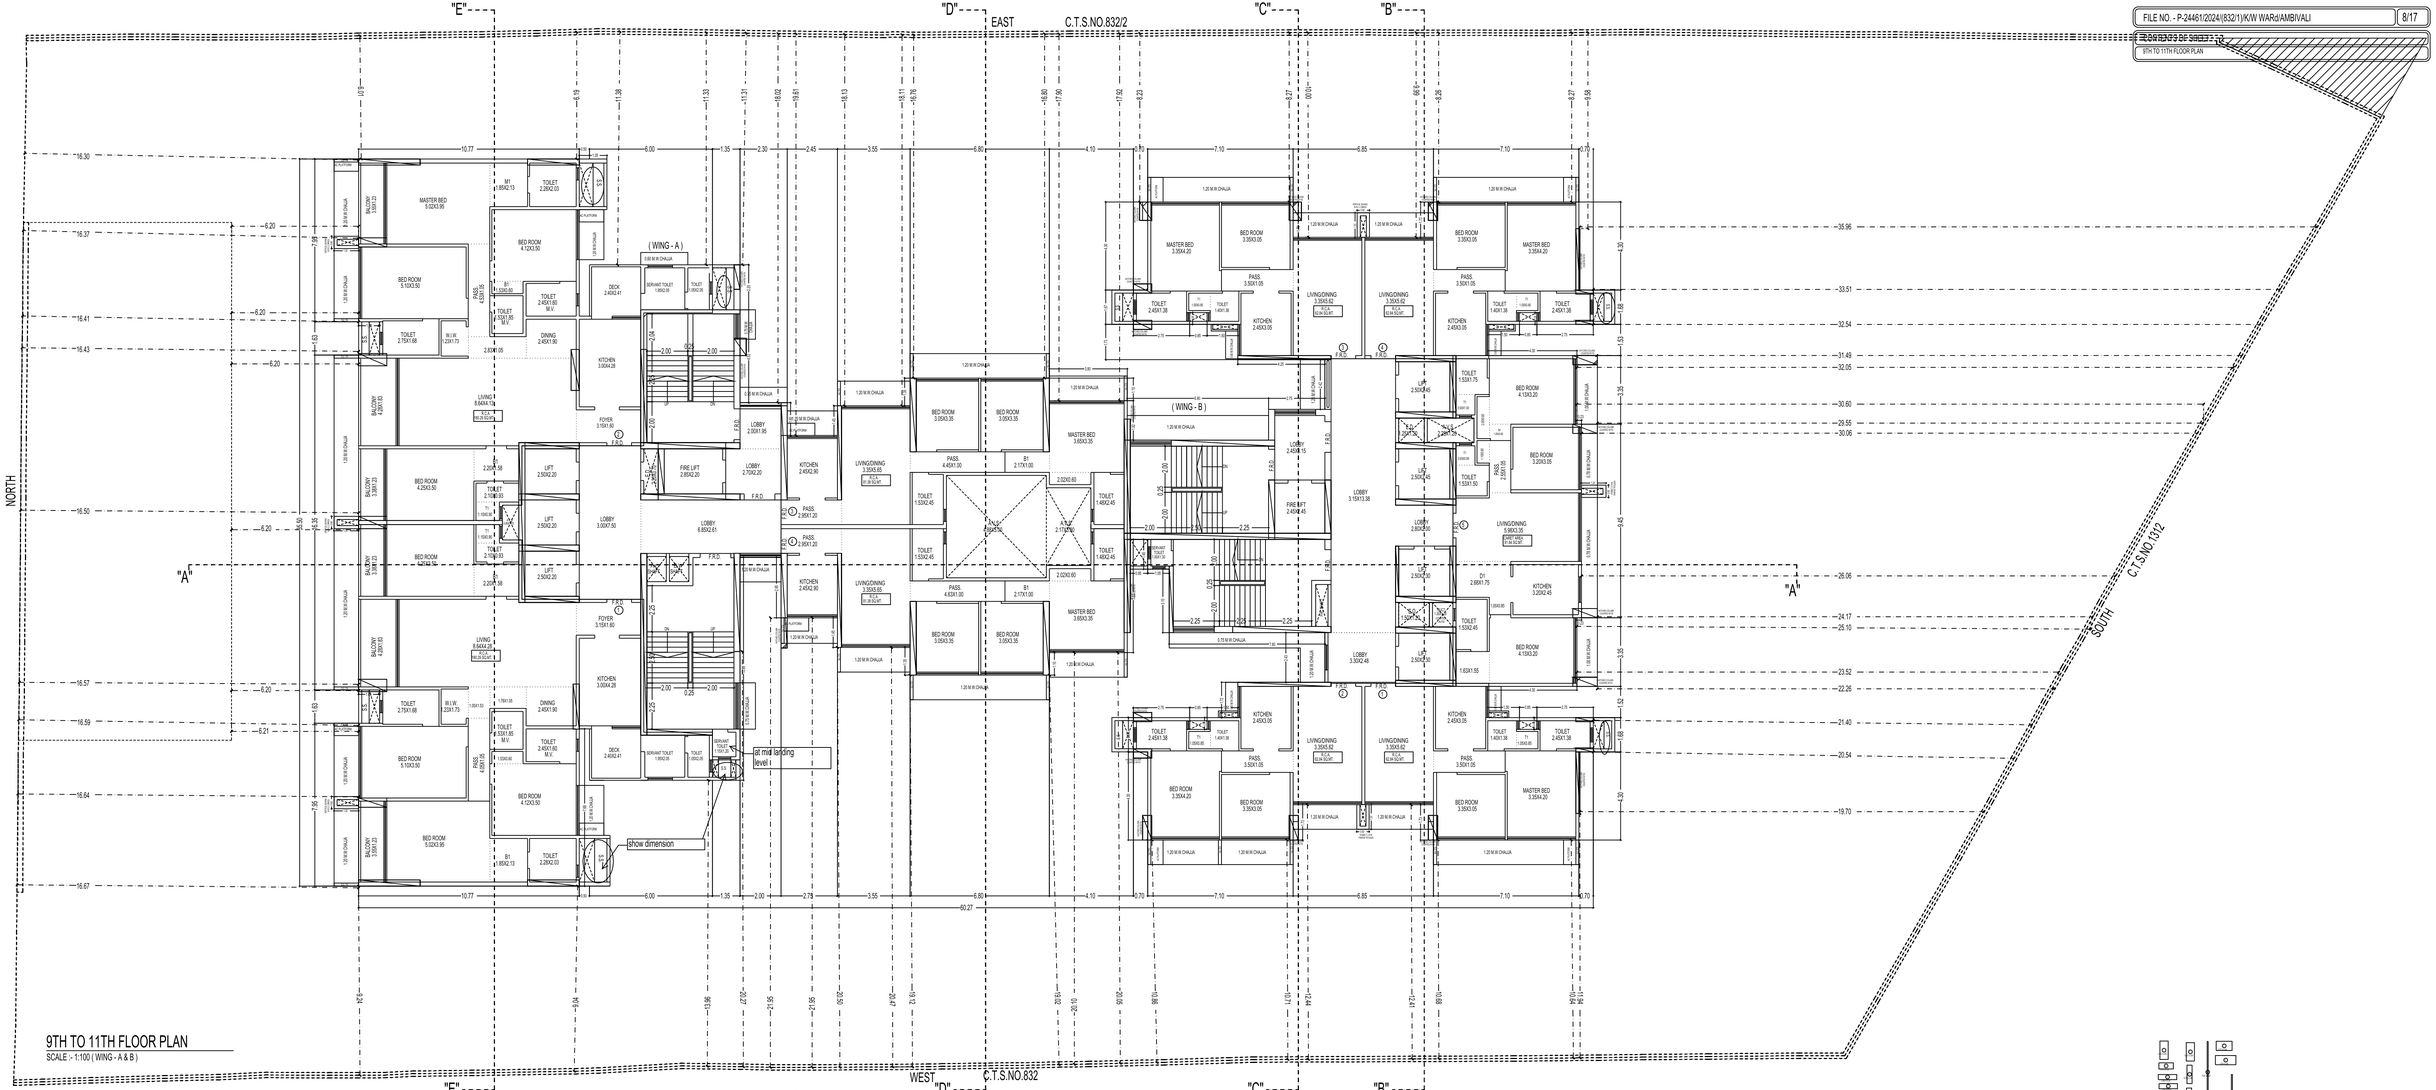

9TH TO 11TH FLOOR PLAN

SCALE :- 1:100 (WING - A & B)

12TH FLOOR PLAN

SCALE :- 1:100 (WING - A & B)

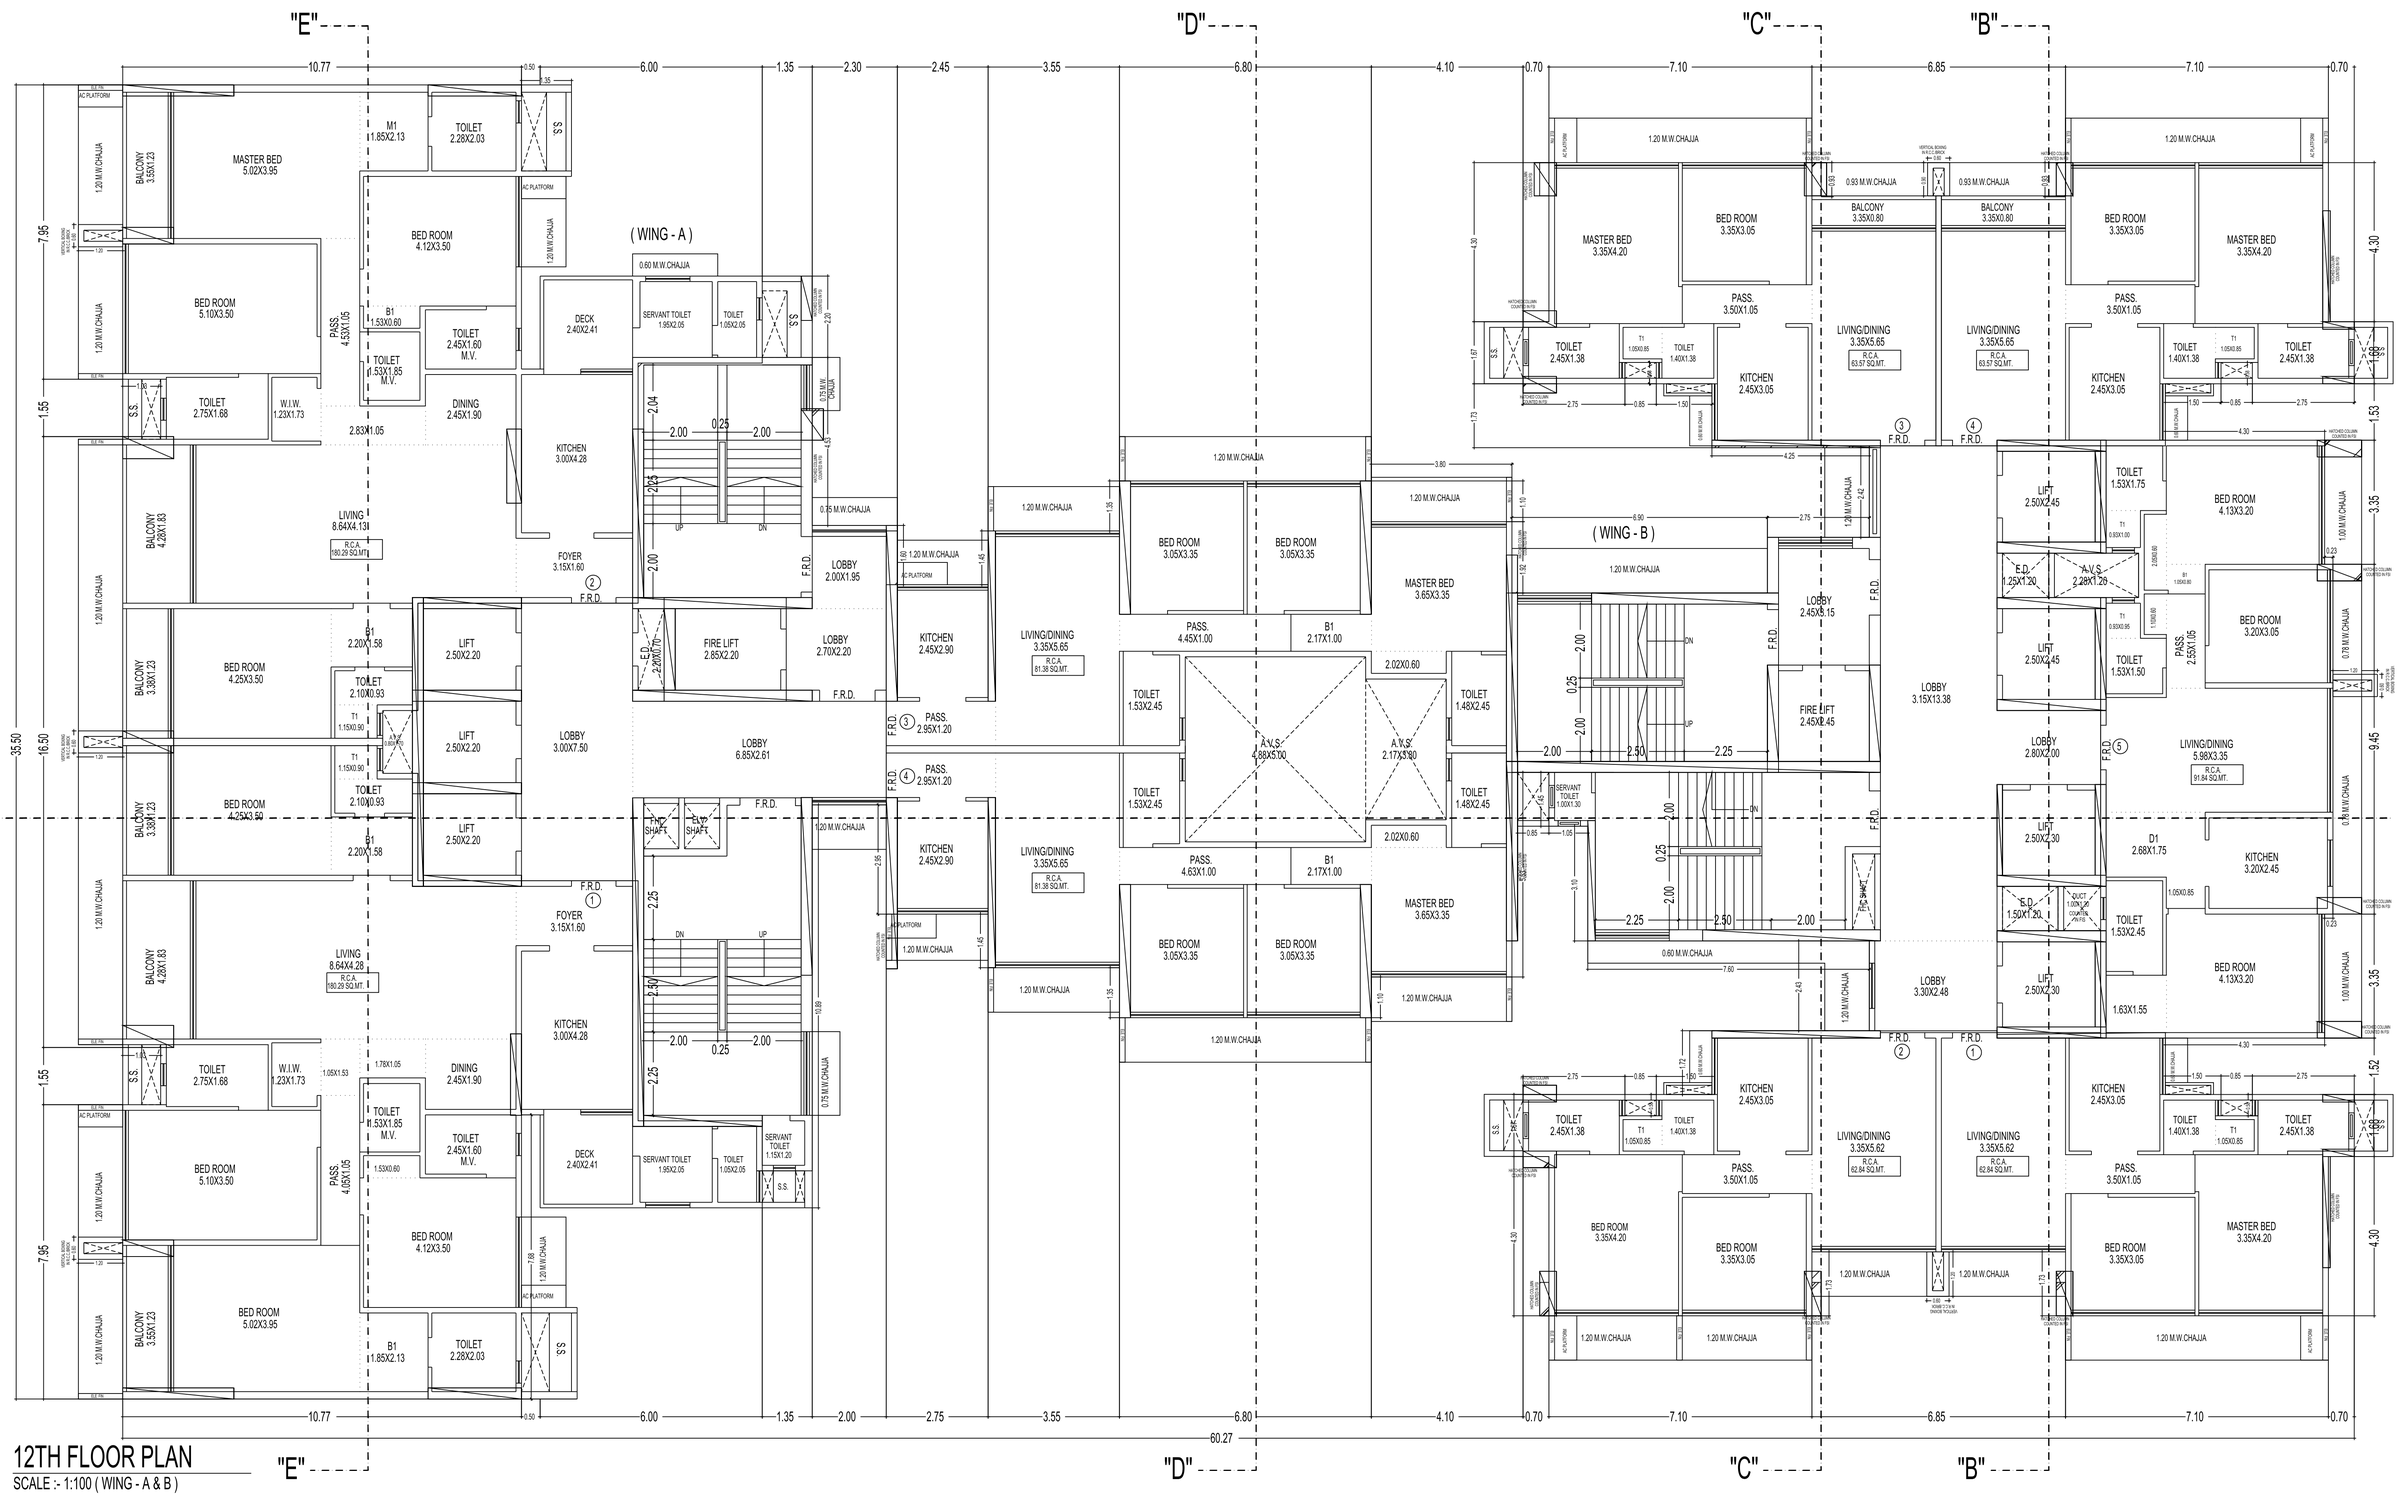
"E"
"D"
"C"
"B"
"A"
(WING - A)
(WING - B)
10.77
6.00
1.35
2.30
2.45
3.55
6.80
4.10
0.70
7.10
6.85
7.10
0.70
60.27
35.50
16.50
7.95
1.55
4.30
1.53
3.35
9.45
1.52
4.30
M1 1.85X2.13
TOILET 2.28X2.03
MASTER BED 5.02X3.95
BALCONY 3.55X1.23
1.20 M.W.CHAJJA
BED ROOM 4.12X3.50
BED ROOM 5.10X3.50
PASS. 4.53X1.05
B1 1.53X0.60
TOILET 2.45X1.60 M.V.
T1 1.53X1.95 M.V.
TOILET 2.75X1.68
W.I.W. 1.23X1.73
DINING 2.45X1.90
2.83X1.05
KITCHEN 3.00X4.28
BALCONY 4.28X1.83
LIVING 8.64X4.13
R.C.A. 180.29 SQ.MT.
FOYER 3.15X1.60
BALCONY 3.38X1.23
BED ROOM 4.25X3.50
B1 2.20X1.58
TOILET 2.10X0.93
T1 1.15X0.90
A.V.S.
LIFT 2.50X2.20
LOBBY 3.00X7.50
BALCONY 3.38X1.23
BED ROOM 4.25X3.50
TOILET 2.10X0.93
LIFT 2.50X2.20
BALCONY 3.55X1.23
BED ROOM 5.02X3.95
B1 1.85X2.13
TOILET 2.28X2.03
S.S.
AC PLATFORM
1.20 M.W.CHAJJA
(WING - A)
0.60 M.W.CHAJJA
SERVANT TOILET 1.95X2.05
TOILET 1.05X2.05
DECK 2.40X2.41
0.75 M.W.CHAJJA
0.35 M.W.CHAJJA
2.04
2.00
0.25
2.00
2.25
2.00
UP
DN
LOBBY 2.00X1.95
F.R.D.
E.D. 2.20X0.70
FIRE LIFT 2.85X2.20
LOBBY 2.70X2.20
LOBBY 6.85X2.61
KITCHEN 2.45X2.90
LIVING/DINING 3.35X5.65
R.C.A. 81.38 SQ.MT.
PASS. 2.95X1.20
PASS. 2.95X1.20
LIFT SHAFT
LIFT SHAFT
1.45
2.85
2.50
2.25
10.99
1.20 M.W.CHAJJA
1.35
1.10
3.80
BED ROOM 3.05X3.35
BED ROOM 3.05X3.35
PASS. 4.45X1.00
B1 2.17X1.00
MASTER BED 3.65X3.35
TOILET 1.53X2.45
TOILET 1.48X2.45
A.V.S. 4.88X5.00
A.V.S. 2.17X3.80
2.02X0.60
PASS. 4.63X1.00
B1 2.17X1.00
MASTER BED 3.65X3.35
BED ROOM 3.05X3.35
BED ROOM 3.05X3.35
1.20 M.W.CHAJJA
1.10
1.62
(WING - B)
6.90
2.75
1.20 M.W.CHAJJA
2.42
LOBBY 2.45X3.15
F.R.D.
FIRE LIFT 2.45X2.45
LOBBY 3.15X13.38
LOBBY 2.80X2.00
LIVING/DINING 5.98X3.35
R.C.A. 91.84 SQ.MT.
SERVANT TOILET 1.00X1.30
2.00
0.25
2.00
2.25
2.50
2.00
UP
DN
LIFT SHAFT
0.60 M.W.CHAJJA
7.60
2.43
1.20 M.W.CHAJJA
LOBBY 3.30X2.48
1.20 M.W.CHAJJA
1.20 M.W.CHAJJA
1.20 M.W.CHAJJA
1.20 M.W.CHAJJA
1.20 M.W.CHAJJA
1.20 M.W.CHAJJA
1.20 M.W.CHAJJA
1.20 M.W.CHAJJA
1.20 M.W.CHAJJA
1.20 M.W.CHAJJA
1.20 M.W.CHAJJA
1.20 M.W.CHAJJA
1.20 M.W.CHAJJA
0.93 M.W.CHAJJA
0.93 M.W.CHAJJA
BALCONY 3.35X0.80
BALCONY 3.35X0.80
BED ROOM 3.35X3.05
MASTER BED 3.35X4.20
BED ROOM 3.35X3.05
MASTER BED 3.35X4.20
PASS. 3.50X1.05
PASS. 3.50X1.05
LIVING/DINING 3.35X5.65
R.C.A. 63.57 SQ.MT.
LIVING/DINING 3.35X5.65
R.C.A. 63.57 SQ.MT.
TOILET 2.45X1.38
T1 1.05X0.85
TOILET 1.40X1.38
KITCHEN 2.45X3.05
TOILET 1.40X1.38
T1 1.05X0.85
TOILET 2.45X1.38
KITCHEN 2.45X3.05
F.R.D.
F.R.D.
LIFT 2.50X2.45
TOILET 1.53X1.75
BED ROOM 4.13X3.20
E.D. 1.25X1.20
A.V.S. 2.28X1.20
LIFT 2.50X2.45
TOILET 1.53X1.50
BED ROOM 3.20X3.05
PASS. 2.53X1.05
D1 2.68X1.75
KITCHEN 3.20X2.45
S.D. 1.50X1.20
DUCT 1.00X1.20
LIFT 2.50X2.30
TOILET 1.53X2.45
BED ROOM 4.13X3.20
1.63X1.55
0.60 M.W.CHAJJA
0.75 M.W.CHAJJA
1.00 M.W.CHAJJA
1.00 M.W.CHAJJA
0.23
0.45
0.60 M.W.CHAJJA
1.20 M.W.CHAJJA
1.20 M.W.CHAJJA
1.20 M.W.CHAJJA
1.20 M.W.CHAJJA
1.20 M.W.CHAJJA
1.20 M.W.CHAJJA
1.20 M.W.CHAJJA
1.20 M.W.CHAJJA
1.20 M.W.CHAJJA
1.20 M.W.CHAJJA
1.20 M.W.CHAJJA
1.20

14TH FLOOR PLAN

"A" "E" "D" "C"

(WING - A)

(WING - B)

MASTER BED 5.02X3.95
BED ROOM 5.10X3.50
BED ROOM 4.25X3.50
BED ROOM 4.12X3.50
M1 1.85X2.13
TOILET 2.28X2.03
B1 1.53X0.60
TOILET 2.45X1.60 M.V.
TOILET 1.53X1.85 M.V.
PASS. 4.53X1.05
PASS. 4.05X1.05
TOILET 2.75X1.68
W.I.W. 1.23X1.73
DINING 2.45X1.90
LIVING 8.64X4.13
R.C.A. 180.29 SQ.MT.
KITCHEN 3.00X4.28
FOYER 3.15X1.60
BALCONY 4.28X1.83
BALCONY 3.55X1.23
BALCONY 3.38X1.23
1.20 M.W.CHAJJA
AC PLATFORM
DECK 2.40X2.41
SERVANT TOILET 1.95X2.05
TOILET 1.05X2.05
0.60 M.W.CHAJJA
0.75 M.W.CHAJJA
S.S.
LIFT 2.50X2.20
LOBBY 3.00X7.50
LOBBY 6.85X2.61
LOBBY 2.70X2.20
FIRE LIFT 2.85X2.20
E.D. 2.20X0.70
B1 2.20X1.58
T1 1.15X0.90
TOILET 2.10X0.93
A.V.S.
F.R.D.
UP
DN
2.00
0.25
2.04
2.25
2.60
2.63
KITCHEN 2.45X2.90
PASS. 2.95X1.20
LIVING/DINING 3.35X5.65
R.C.A. 86.56 SQ.MT.
BALCONY 2.00X1.50
TOILET 2.25X1.50
BALCONY 2.05X1.50
BED ROOM 3.05X3.35
PASS. 4.63X1.00
M1 2.17X1.00
M2 2.97X0.60
TOILET 1.53X2.45
TOILET 1.48X2.45
A.V.S. 3.93X5.00
A.V.S. 3.12X3.80
MASTER BED 3.65X3.35
1.20 M.W.CHAJJA
1.65
2.65
2.71
3.80
4.10
6.80
3.55
2.45
2.75
2.00
1.35
6.00
10.77
0.50
1.35
7.95
1.55
16.50
35.50
60.27
MASTER BED 3.35X4.20
BED ROOM 3.35X3.05
PASS. 3.50X1.05
TOILET 2.45X1.38
TOILET 1.40X1.38
T1 1.05X0.85
KITCHEN 2.45X3.05
LIVING/DINING 3.35X5.65
R.C.A. 63.57 SQ.MT.
BALCONY 3.35X0.80
0.90 M.W.CHAJJA
1.20 M.W.CHAJJA
HATCHED COLUMN COUNTED IN FSI
SERVANT TOILET 1.00X1.30
LOBBY 2.45X3.15
FIRE LIFT 2.45X2.45
LOBBY 3.15X13.38
LOBBY 3.30X2.48
LOBBY 2.80X2.00
LIFT 2.50X2.45
LIFT 2.50X2.30
TOILET 1.53X1.75
TOILET 1.53X1.50
TOILET 1.53X2.45
BED ROOM 4.13X3.20
BED ROOM 3.20X3.05
KITCHEN 3.20X2.45
LIVING/DINING 5.98X3.35
R.C.A. 92.34 SQ.MT.
D1 2.68X1.75
S.D. 1.50X1.20
E.D. 1.25X1.20
A.V.S. 2.28X1.20
PASS. 2.55X1.05
1.63X1.55
BALCONY 3.35X1.15
0.78 M.W.CHAJJA
1.00 M.W.CHAJJA
F.R.D.
0.70
7.10
6.85
7.35
6.60
4.30
4.25
6.90
7.60

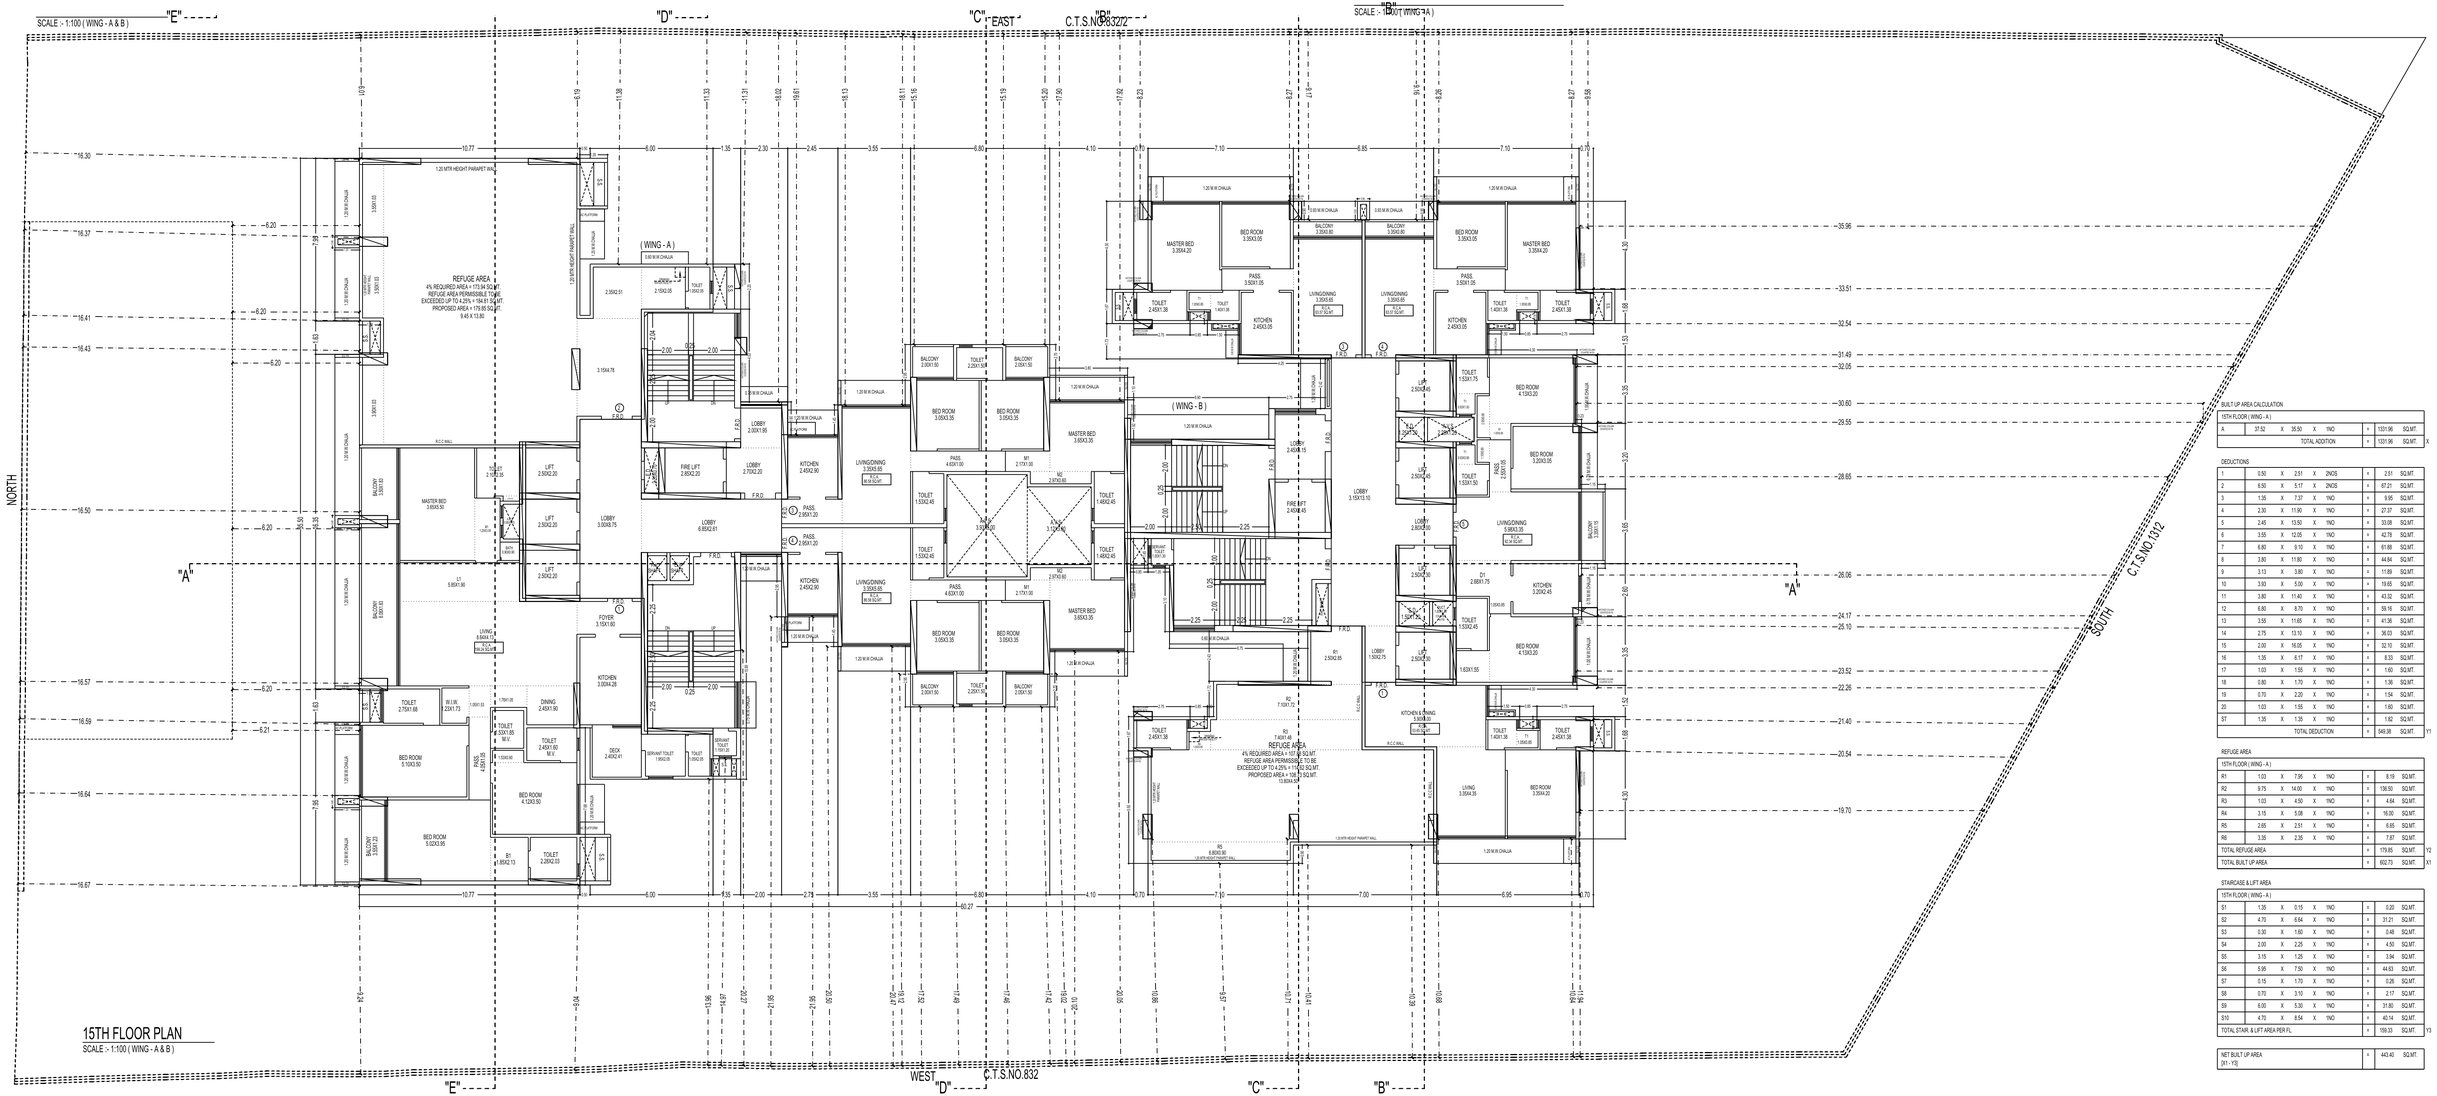

15TH FLOOR PLAN

SCALE :- 1:100 (WING - A & B)

BUILT UP AREA CALCULATION

15TH FLOOR (WING - A)							
A	37.52	X	35.53	X	1NO	=	1331.96 SQ.MT.
			TOTAL ADDITION			=	1331.96 SQ.MT. X

DEDUCTIONS

1	0.50	X	2.51	X	2NOS	=	2.51 SQ.MT.
2	6.50	X	5.17	X	2NOS	=	67.21 SQ.MT.
3	1.35	X	7.37	X	1NO	=	9.95 SQ.MT.
4	2.30	X	11.90	X	1NO	=	27.37 SQ.MT.
5	2.45	X	13.50	X	1NO	=	33.08 SQ.MT.
6	3.55	X	12.05	X	1NO	=	42.78 SQ.MT.
7	6.80	X	9.10	X	1NO	=	61.88 SQ.MT.
8	3.80	X	11.80	X	1NO	=	44.84 SQ.MT.
9	3.13	X	3.80	X	1NO	=	11.89 SQ.MT.
10	3.93	X	5.00	X	1NO	=	19.65 SQ.MT.
11	3.80	X	11.40	X	1NO	=	43.32 SQ.MT.
12	6.80	X	8.70	X	1NO	=	59.16 SQ.MT.
13	3.55	X	11.65	X	1NO	=	41.36 SQ.MT.
14	2.75	X	13.10	X	1NO	=	36.03 SQ.MT.
15	2.00	X	16.05	X	1NO	=	32.10 SQ.MT.
16	1.35	X	6.17	X	1NO	=	8.33 SQ.MT.
17	1.03	X	1.55	X	1NO	=	1.60 SQ.MT.
18	0.80	X	1.70	X	1NO	=	1.36 SQ.MT.
19	0.70	X	2.20	X	1NO	=	1.54 SQ.MT.
20	1.03	X	1.55	X	1NO	=	1.60 SQ.MT.
97	1.35	X	1.35	X	1NO	=	1.82 SQ.MT.
			TOTAL DEDUCTION			=	549.38 SQ.MT. Y1

REFUGE AREA

15TH FLOOR (WING - A)							
R1	1.03	X	7.95	X	1NO	=	8.19 SQ.MT.
R2	9.75	X	14.00	X	1NO	=	136.50 SQ.MT.
R3	1.03	X	4.50	X	1NO	=	4.64 SQ.MT.
R4	3.15	X	5.08	X	1NO	=	16.00 SQ.MT.
R5	2.65	X	2.51	X	1NO	=	6.65 SQ.MT.
R6	3.35	X	2.35	X	1NO	=	7.87 SQ.MT.
TOTAL REFUGE AREA						=	179.85 SQ.MT. Y2
TOTAL BUILT UP AREA						=	902.73 SQ.MT. X1

STAIRCASE & LIFT AREA

15TH FLOOR (WING - A)							
S1	1.35	X	0.15	X	1NO	=	0.20 SQ.MT.
S2	4.70	X	8.64	X	1NO	=	37.21 SQ.MT.
S3	0.30	X	1.60	X	1NO	=	0.48 SQ.MT.
S4	2.00	X	2.25	X	1NO	=	4.50 SQ.MT.
S5	3.15	X	1.25	X	1NO	=	3.94 SQ.MT.
S6	5.95	X	7.50	X	1NO	=	44.63 SQ.MT.
S7	0.15	X	1.70	X	1NO	=	0.26 SQ.MT.
S8	0.70	X	3.10	X	1NO	=	2.17 SQ.MT.
S9	6.00	X	5.30	X	1NO	=	31.80 SQ.MT.
S10	4.70	X	8.54	X	1NO	=	40.14 SQ.MT.
TOTAL STAIR, & LIFT AREA PER FL						=	159.33 SQ.MT. Y3

NET BUILT UP AREA (X1 - Y3)	=	443.40 SQ.MT.

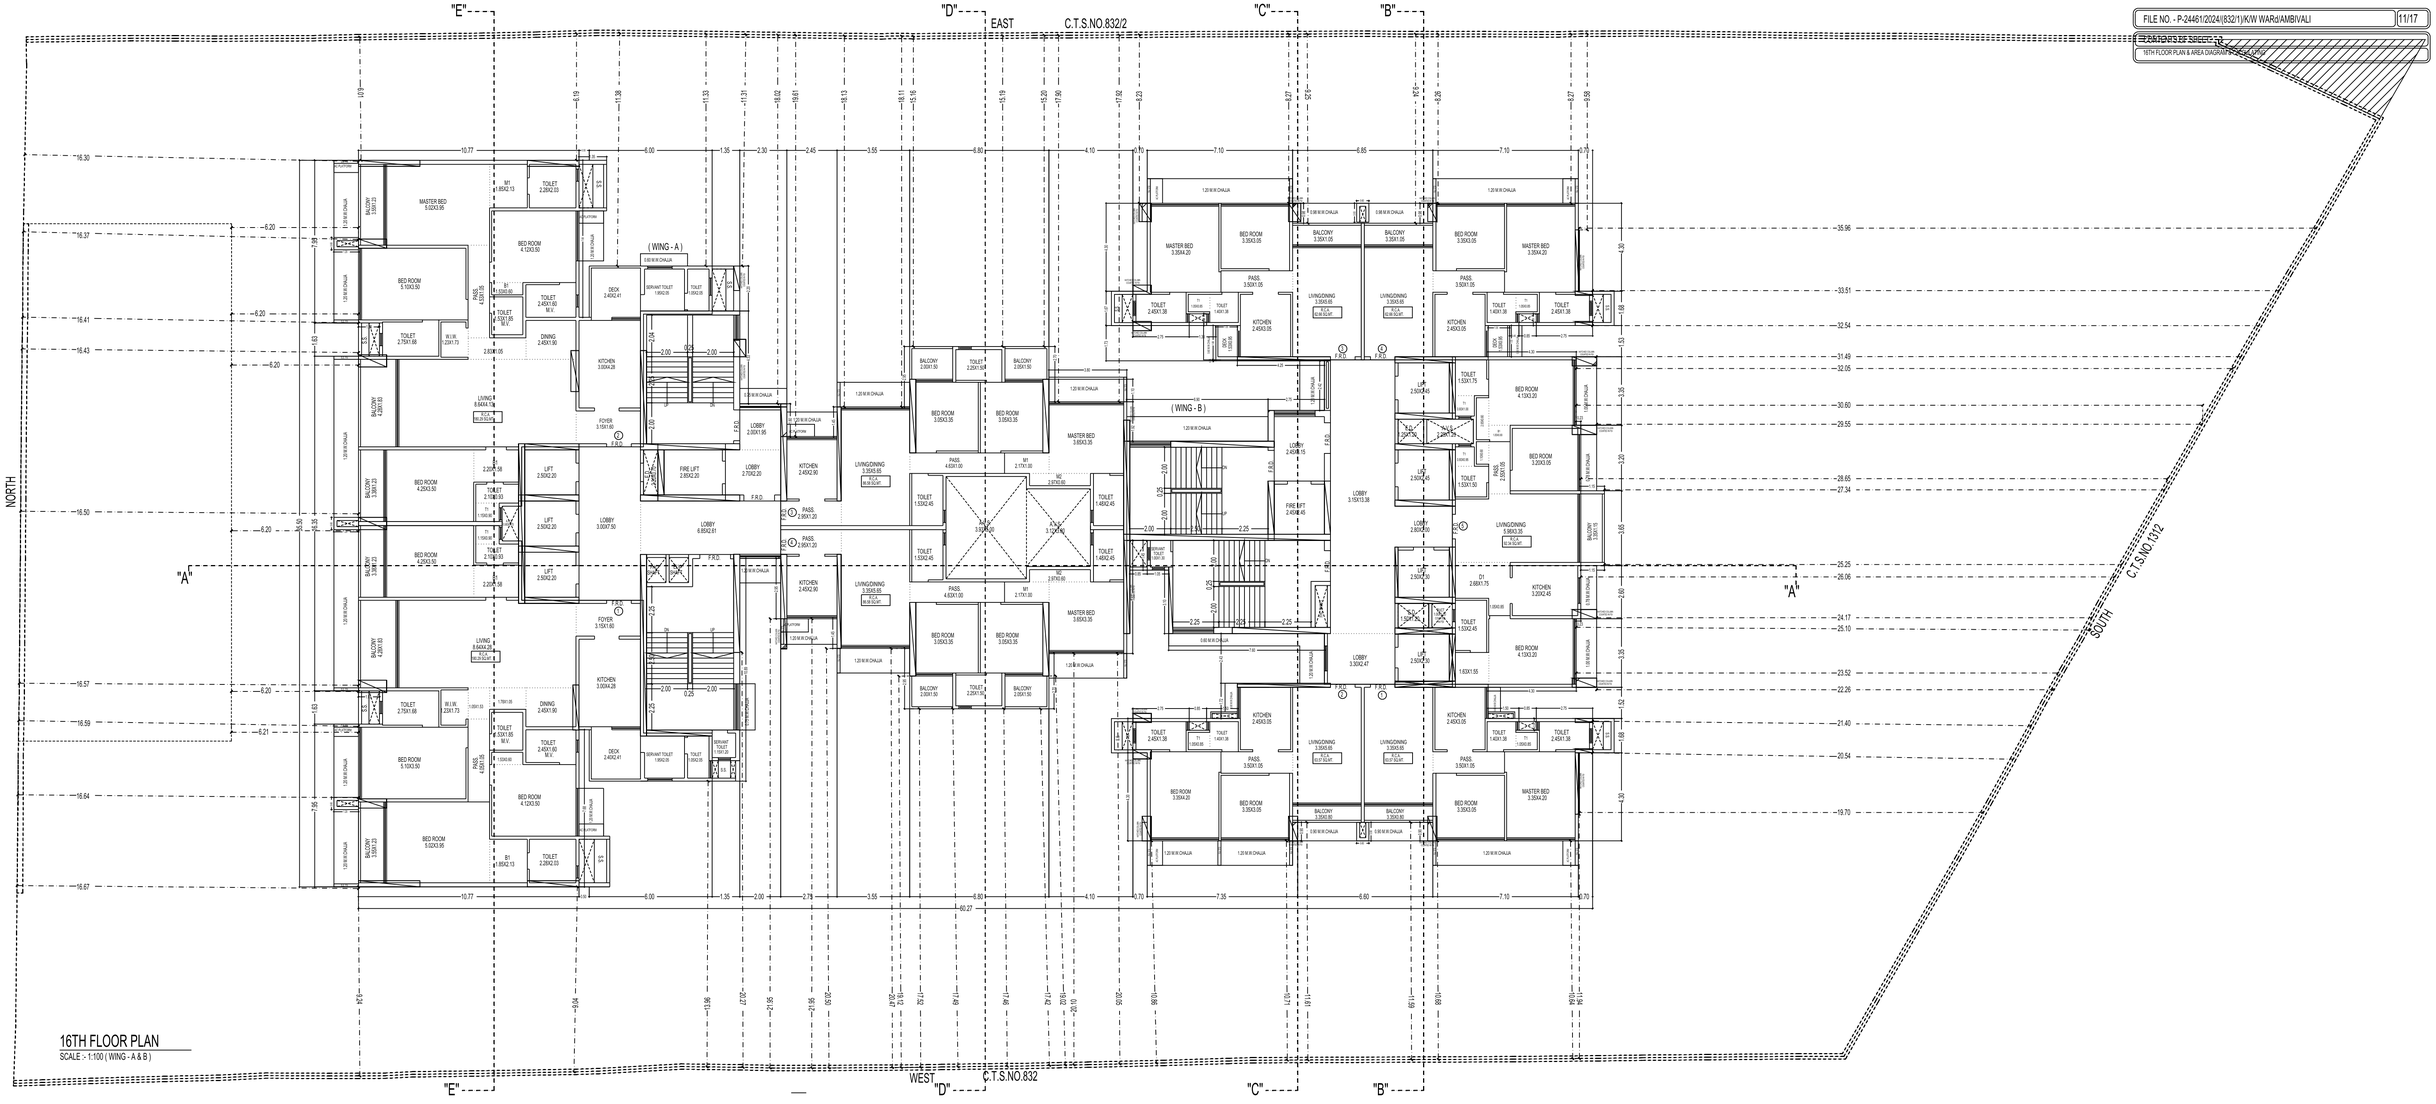

16TH FLOOR PLAN

SCALE :- 1:100 (WING - A & B)

FILE NO. - P-24461/2024/(832/1)/KW WARD/AMBIVALI | 12/17

CONTENTS OF SHEET :-

17TH FLOOR PLAN & AREA DIAGRAM

17TH FLOOR PLAN

SCALE - 1:100 (WING - A & B)

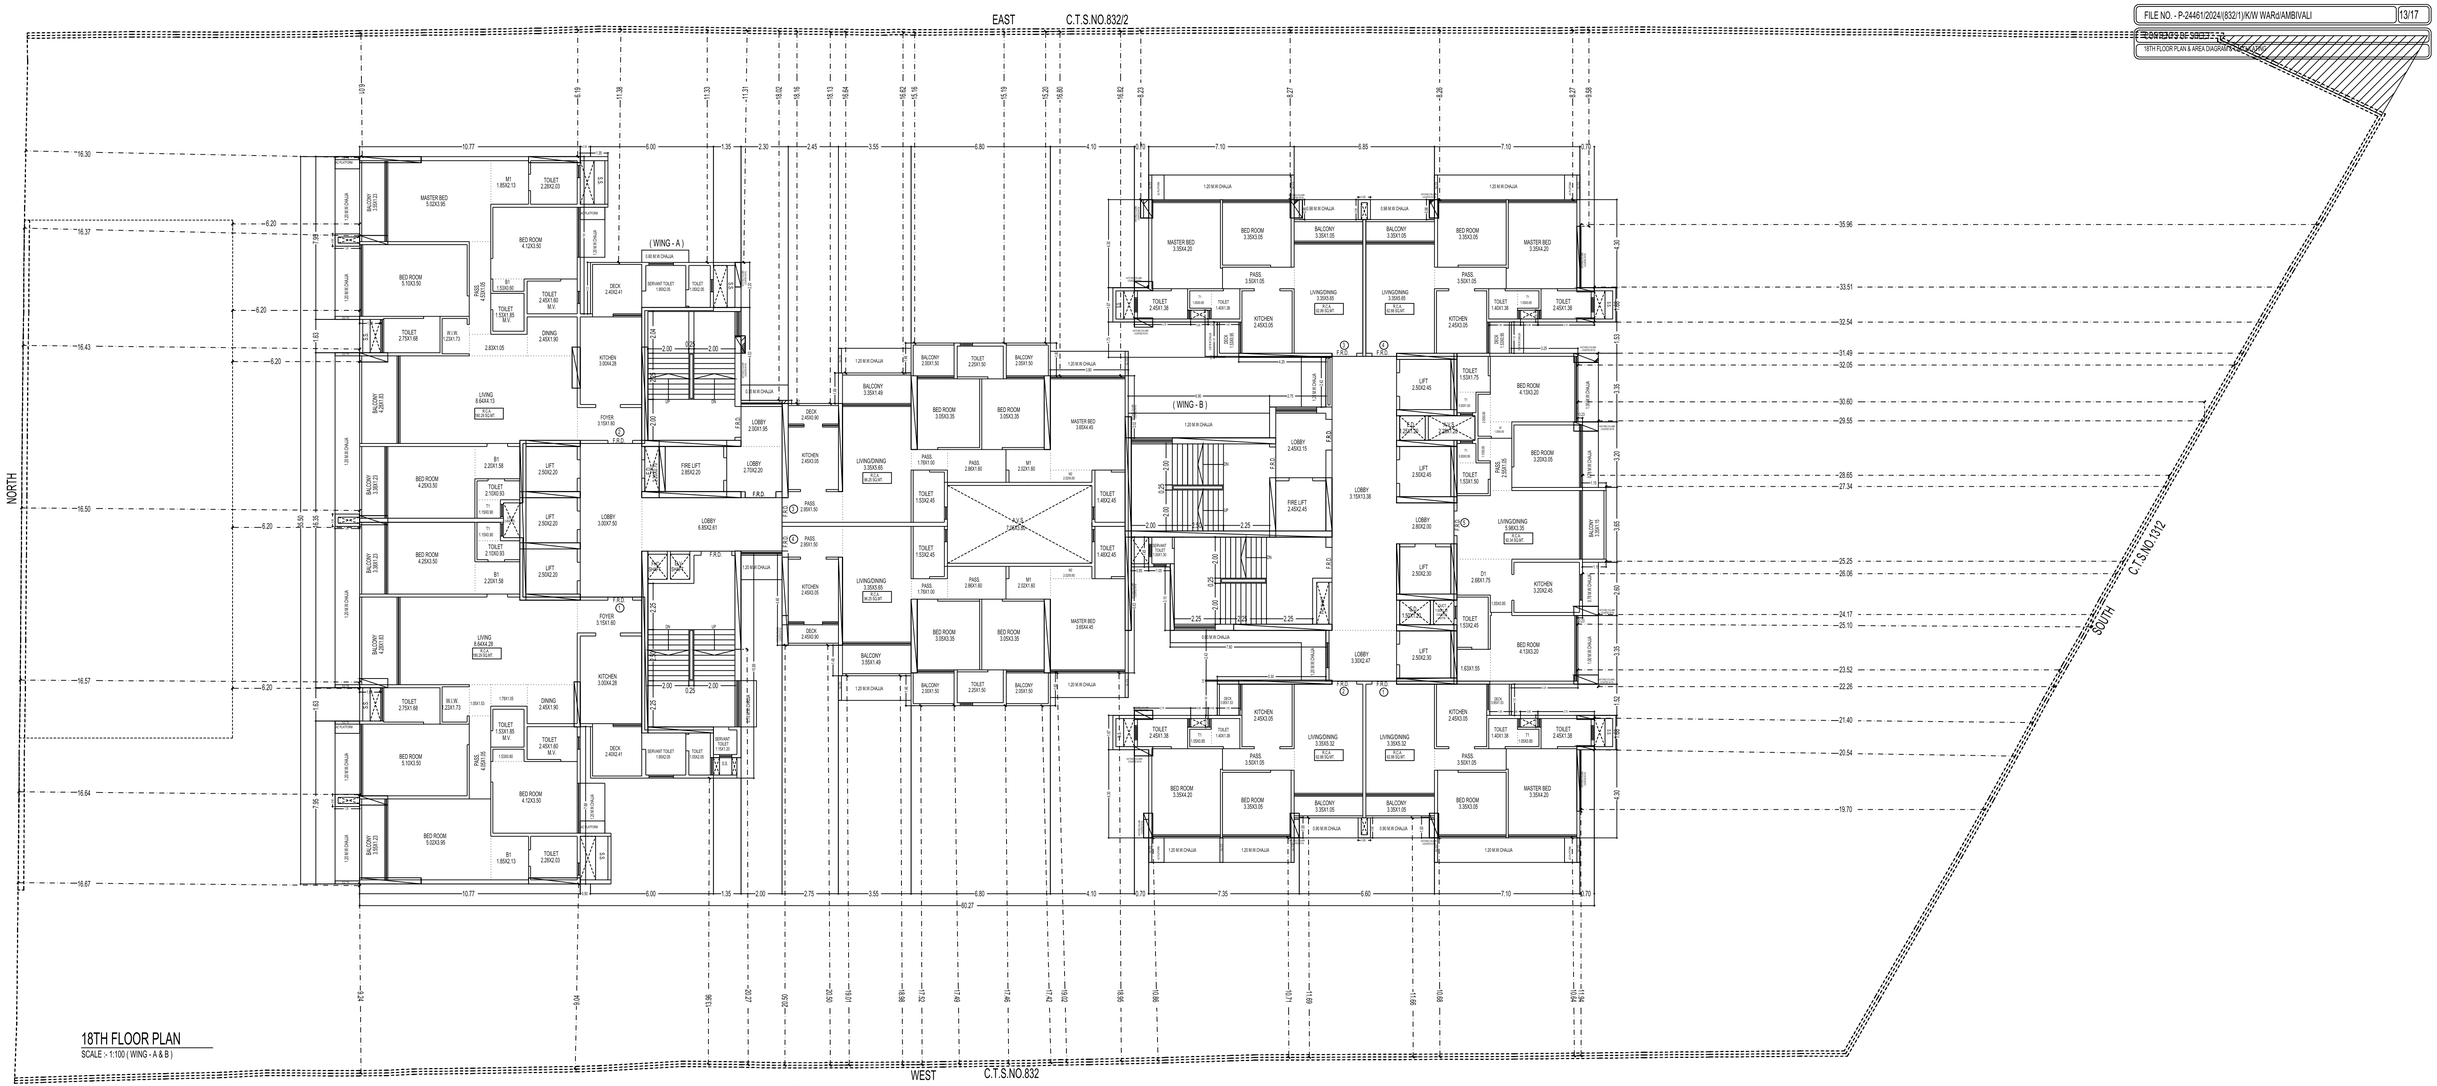

18TH FLOOR PLAN

SCALE :- 1:100 (WING - A & B)

FILE NO. - P-24461/2024/(832/1)/K/W WARd/AMBIVALI | 14/17

19TH TO 21ST FLOOR PLAN & AREA DIAGRAM

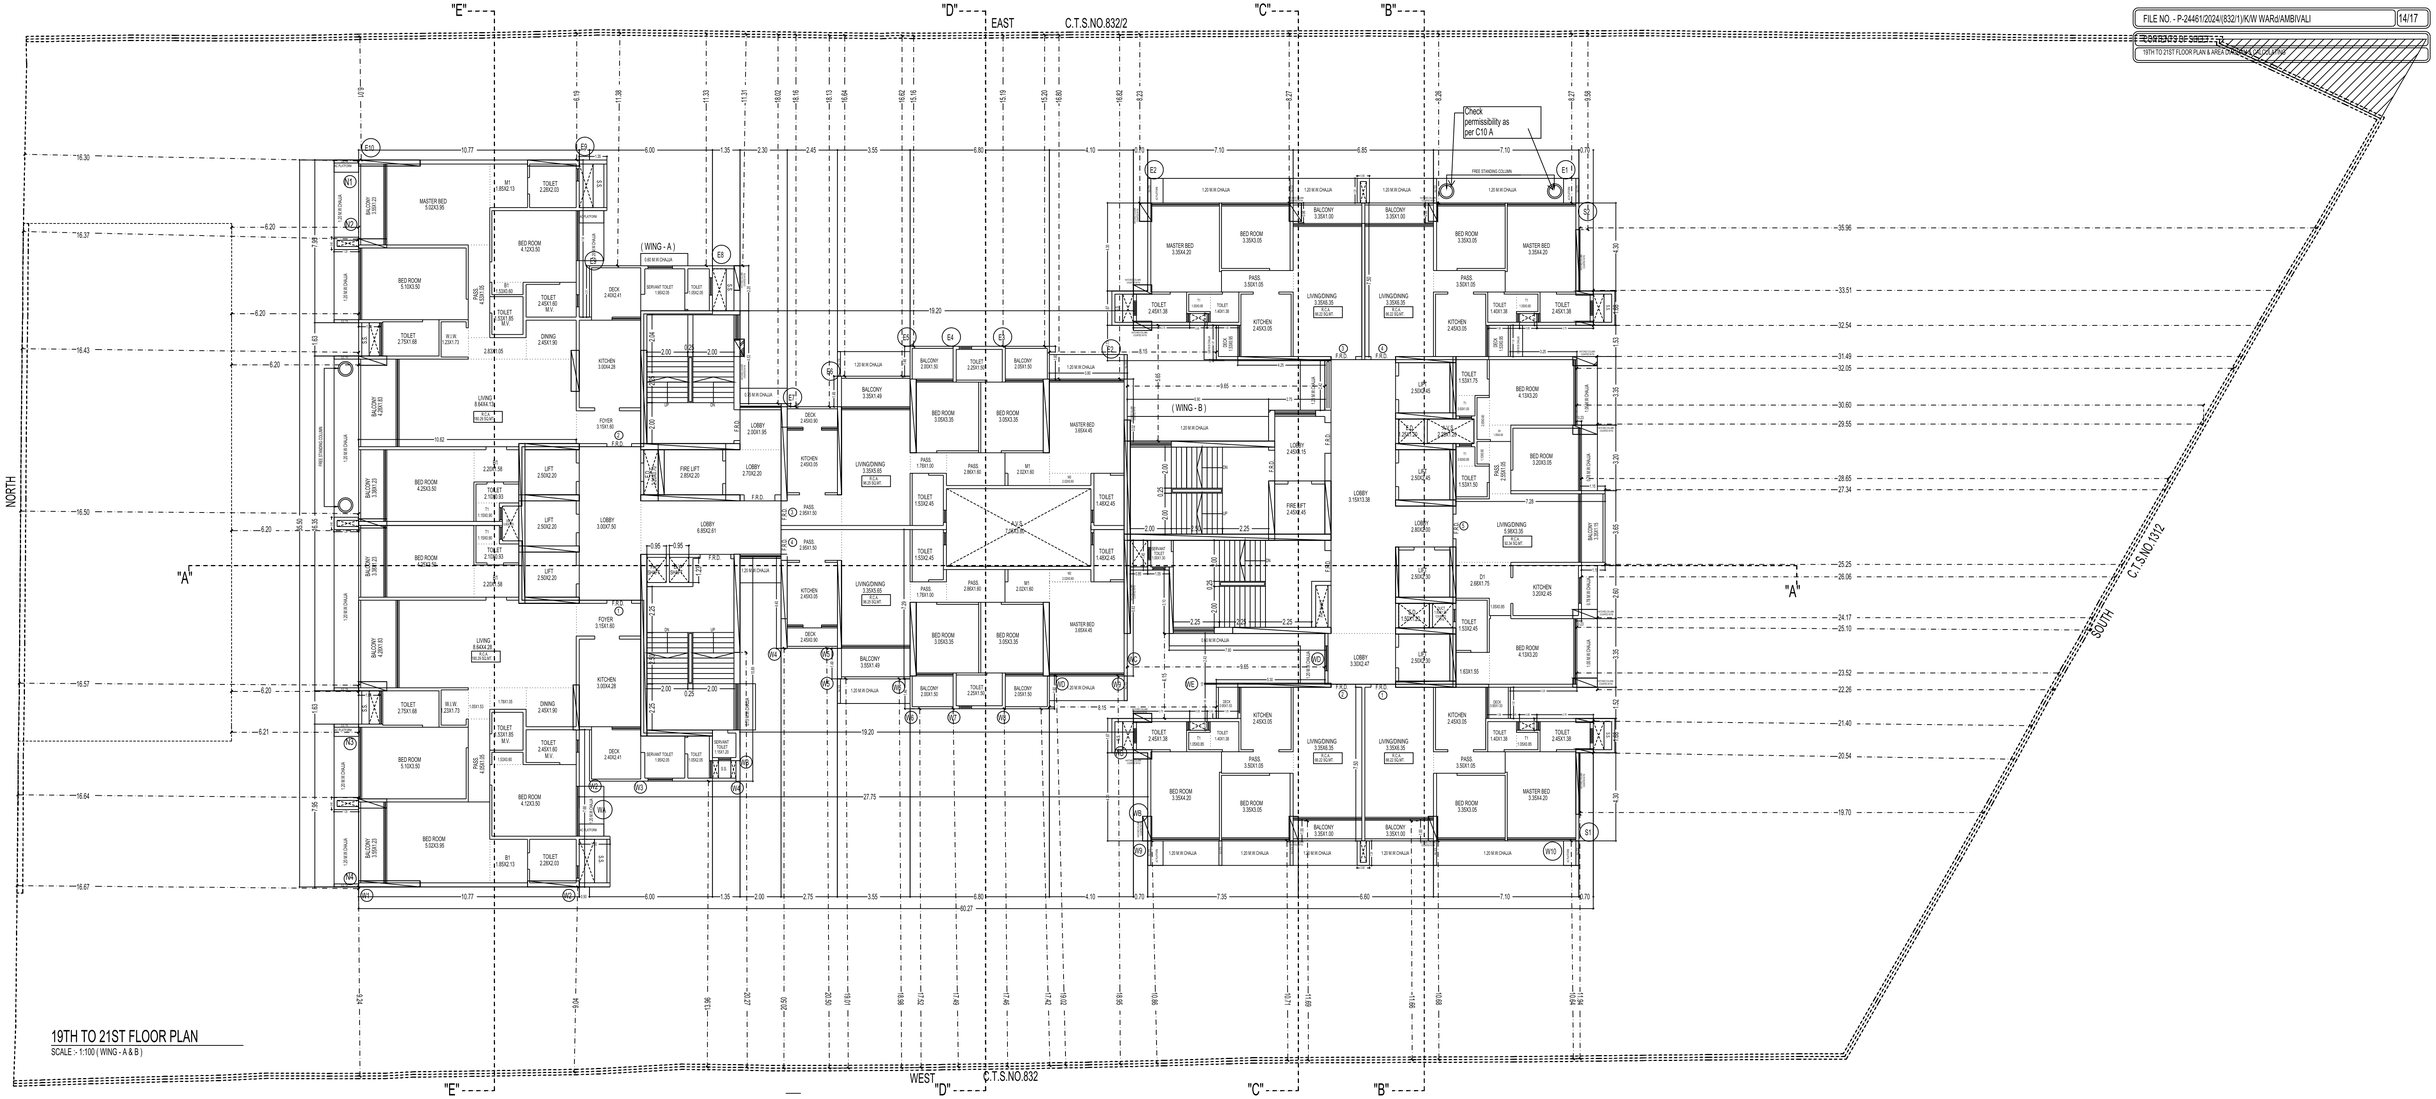
NORTH
SOUTH
EAST
WEST
C.T.S.NO.832/2
C.T.S.NO.832
"A"
"B"
"C"
"D"
"E"
(WING - A)
(WING - B)
Check permissibility as per C10 A
FIRE STANDING COLUMN
MASTER BED 5.02X3.95
BED ROOM 5.10X3.50
BED ROOM 4.12X3.50
BED ROOM 4.25X3.50
TOILET 2.75X1.88
TOILET 2.28X2.03
TOILET 2.45X1.85 M.V.
TOILET 2.45X1.80 M.V.
DINING 2.45X1.90
KITCHEN 3.00X4.28
LIVING 8.64X4.15
FOYER 3.15X1.80
LOBBY 3.00X7.50
LOBBY 6.85X2.61
LOBBY 2.70X2.20
LOBBY 2.00X1.95
LIFT 2.50X2.20
FIRE LIFT 2.85X2.20
DECK 2.40X2.41
SERVANT TOILET 1.95X2.05
DECK 2.45X3.90
KITCHEN 2.45X3.05
LIVING/DINING 3.35X5.65
PASS 1.75X1.00
PASS 2.95X1.50
PASS 2.95X1.80
BED ROOM 3.05X3.35
MASTER BED 3.65X4.45
M1 2.02X1.80
M2 2.02X1.80
4.0 X 4.0 LIFT SHAFT
TOILET 1.53X2.45
TOILET 1.48X2.45
BALCONY 3.05X1.48
BALCONY 3.55X1.48
BALCONY 2.05X1.80
BALCONY 2.05X1.50
TOILET 2.20X1.73
BALCONY 4.20X1.63
BALCONY 3.00X1.85
BALCONY 2.00X1.50
1.20 M.W.CHAJJA
MASTER BED 3.65X4.20
BED ROOM 3.05X3.05
PASS 3.50X1.05
LIVING/DINING 3.05X6.35
KITCHEN 2.45X3.05
TOILET 2.45X1.38
TOILET 1.40X1.38
BALCONY 3.35X1.00
LIFT 2.50X2.45
LOBBY 2.60X1.15
LOBBY 3.15X13.38
FIRE LIFT 2.45X2.45
LOBBY 2.60X2.50
LIVING/DINING 5.98X3.35
BALCONY 2.00X1.15
TOILET 1.53X1.75
TOILET 1.53X1.50
BED ROOM 3.20X3.05
PASS 2.60X1.05
D1 2.66X1.75
KITCHEN 3.20X2.45
TOILET 1.53X2.45
BED ROOM 4.13X3.20
1.63X1.55
LOBBY 3.30X2.47
LIVING/DINING 3.35X6.35
BED ROOM 3.30X3.05
MASTER BED 3.35X4.20
BALCONY 3.35X1.00
W1
W2
W3
W4
W5
W6
W7
W8
W9
W10
S1
S2
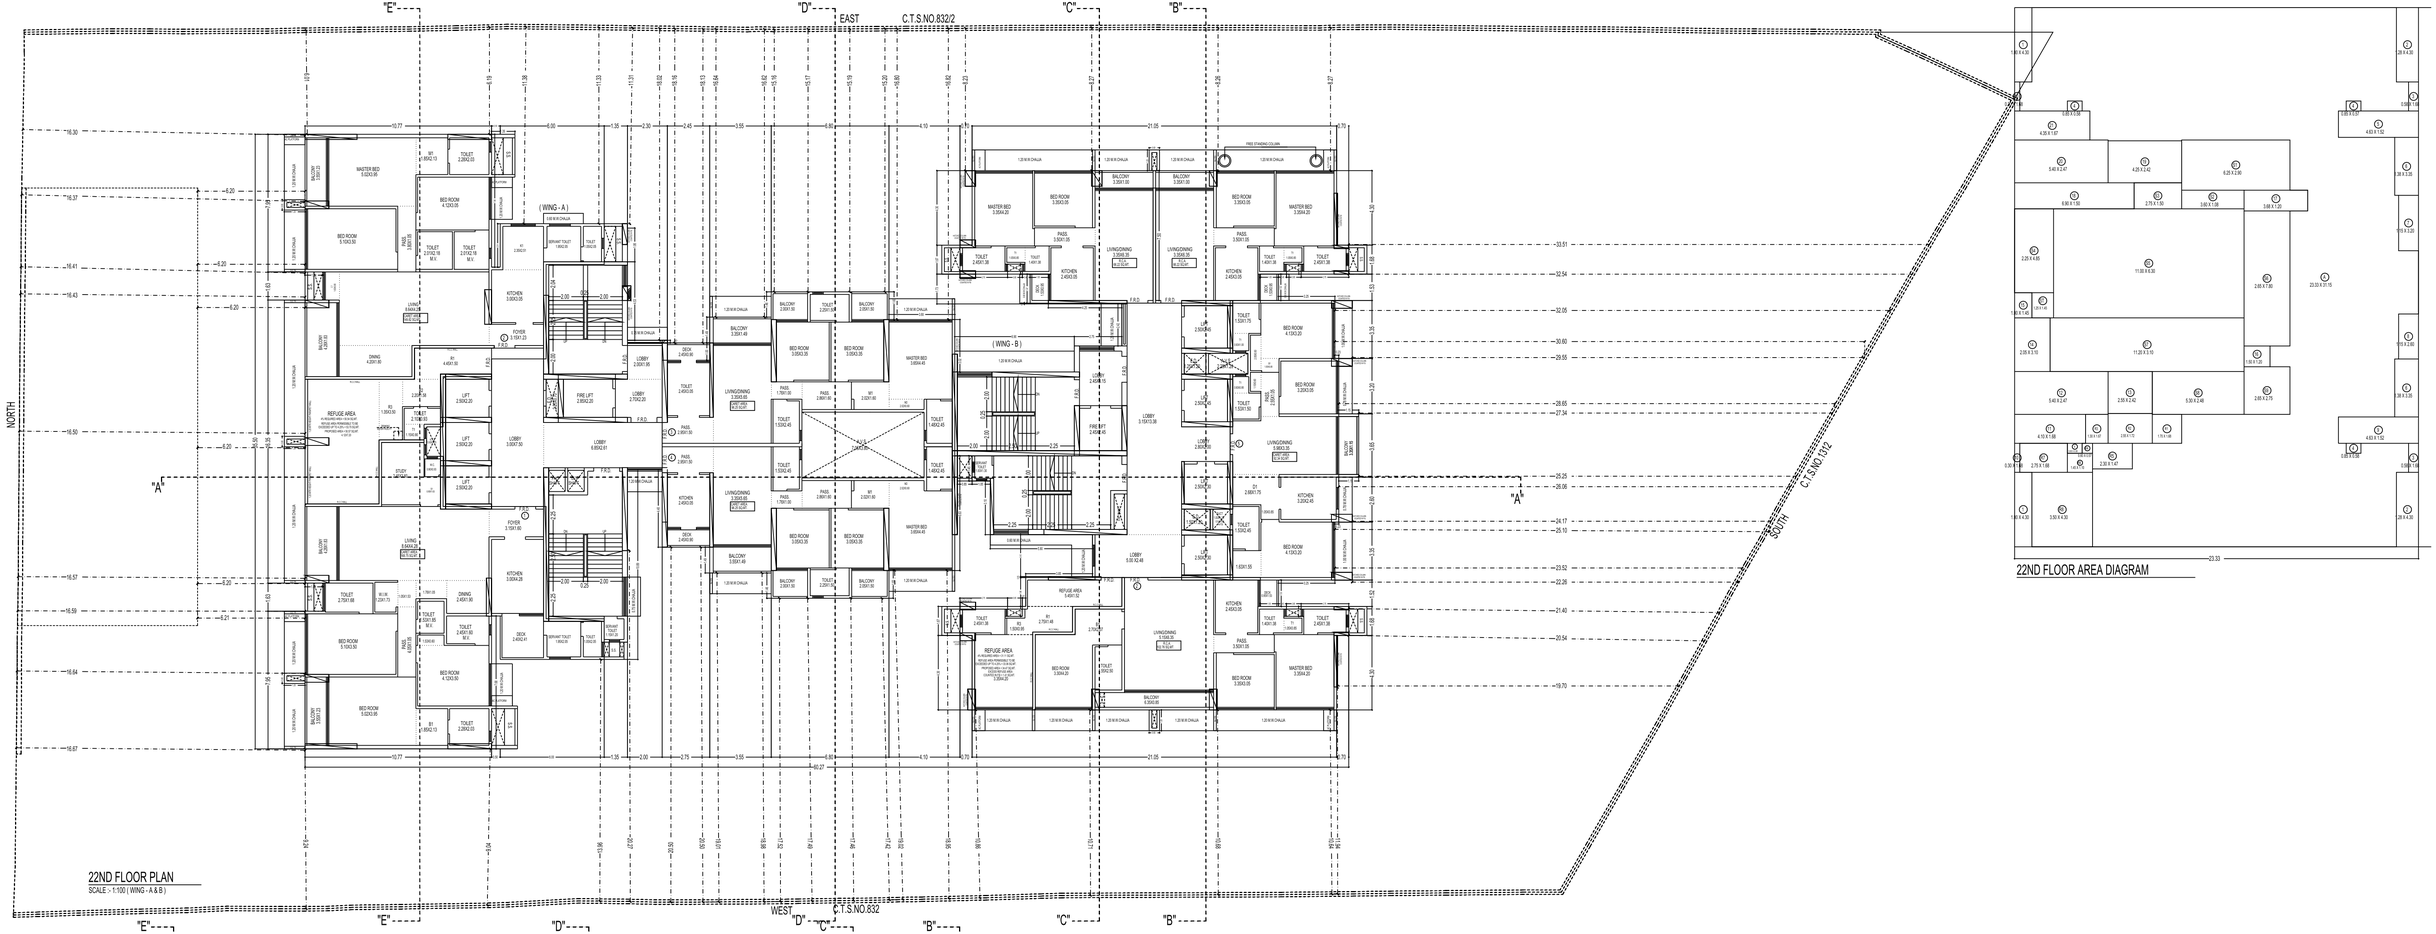

22ND FLOOR PLAN

SCALE - 1:100 (WING - A & B)

22ND FLOOR AREA DIAGRAM



(WING - A)

(WING - B)

"A" "D" "C" "B"

10.77 6.00 1.35 2.30 2.45 3.55 6.80 4.10 0.70 7.10 6.85 7.10 0.70

60.27

35.50 16.35 7.95 1.63 19.20 8.15 9.65 6.90 2.75 4.30 3.35 3.20 3.65 1.53 1.68 4.30 2.60 3.35 1.52 1.68 4.30

MASTER BED 5.02X3.95
M1 1.85X2.13
TOILET 2.28X2.03
BALCONY 3.35X1.23
1.20 M.W.CHAJJA
AC PLATFORM
BED ROOM 4.12X3.50
BED ROOM 5.10X3.50
PASS. 4.35X1.05
B1 1.53X0.60
TOILET 2.45X1.60 M.V.
TOILET 1.53X1.85 M.V.
DECK 2.40X2.41
SERVANT TOILET 1.95X2.05
TOILET 1.05X2.05
0.60 M.W.CHAJJA
S.S.
TOILET 2.75X1.68
W.I.W. 1.23X1.73
DINING 2.45X1.90
KITCHEN 3.00X4.28
LIVING 8.64X4.13
R.C.A. 180.29 SQ.MT.
BALCONY 4.28X1.83
FOYER 3.15X1.80
F.R.D.
0.75 M.W.CHAJJA
LOBBY 2.00X1.95
FIRE LIFT 2.85X2.20
LOBBY 2.70X2.20
LIFT 2.50X2.20
LOBBY 3.00X7.50
LOBBY 6.85X2.61
F.C.D. 2.80X0.70
PNC SHAFT
ELV. SHAFT
PASS. 2.95X1.50
BALCONY 3.35X1.49
LIVING/DINING 3.35X5.65
R.C.A. 96.25 SQ.MT.
BED ROOM 3.05X3.35
BALCONY 2.00X1.50
TOILET 2.25X1.50
BALCONY 2.05X1.50
PASS. 1.78X1.00
PASS. 2.86X1.60
M1 2.02X1.60
M2 2.02X2.60
MASTER BED 3.65X4.45
TOILET 1.53X2.45
TOILET 1.48X2.45
A.V.S. 7.06X3.80
LOBBY 3.15X13.38
LOBBY 2.45X3.15
LIFT 2.45X2.45
SERVANT TOILET 1.00X1.30
MASTER BED 3.35X4.20
BED ROOM 3.35X3.05
PASS. 3.50X1.05
BALCONY 3.35X1.00
LIVING/DINING 3.35X6.35
R.C.A. 66.22 SQ.MT.
KITCHEN 2.45X3.05
TOILET 2.45X1.38
TOILET 1.40X1.38
T1 1.05X0.85
DECK 1.53X0.95
1.20 M.W.CHAJJA
FREE STANDING COLUMN
LIFT 2.50X2.45
TOILET 1.53X1.75
E.D. 1.25X1.20
A.V.S. 2.28X1.20
BED ROOM 4.13X3.20
BED ROOM 3.20X3.05
TOILET 1.53X1.50
LIFT 2.50X2.30
LIVING/DINING 5.98X3.35
R.C.A. 92.34 SQ.MT.
D1 2.66X1.75
S.D. 1.50X1.20
DUCT 1.00X1.20
PIC 2.60
TOILET 1.53X2.45
KITCHEN 3.20X2.45
BED ROOM 4.13X3.20
1.63X1.55
LOBBY 5.00X2.47
BALCONY 3.35X1.15
0.78 M.W.CHAJJA
1.00 M.W.CHAJJA
